

BRAZIER MOTTI PTY LTD. ACN 066 411 041
 595 FLINDERS ST. TOWNSVILLE, HEREBY CERTIFY THAT
 THIS DRAWING ACCURATELY AND CORRECTLY DESCRIBES
 AND RECORDS THE NATURE AND LOCATION OF THE WORKS
 DEPICTED BY AS PERISKS (X) HEREON AS THEY HAVE BEEN
 CONSTRUCTED BY SUBDIVISION.


THE TOWN PLANNING DIRECTOR
 LICENSED SURVEYOR & DIRECTOR
 Date: This 17 day of Nov 2009
 SEAL OF
 ACN 066 411 041

LEGEND


→ DENOTES BATTER TO EXIST. AT 1 IN 6 SLOPE

16.924 AS CONSTRUCTED EARTHWORKS LEVEL


TOP OF BATTER

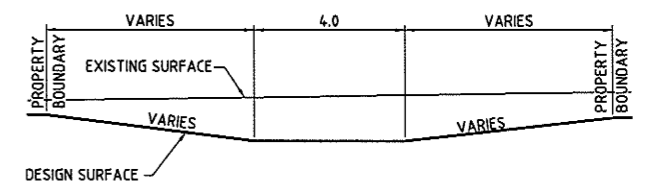

SWALE SECTION - A
NOT TO SCALE

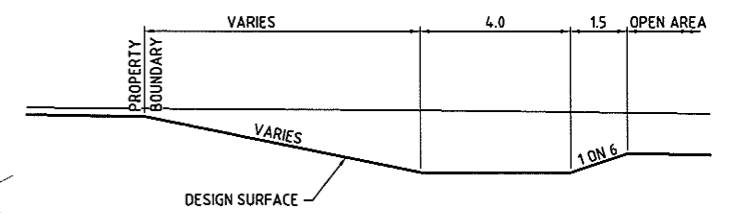


SWALE SECTION - B
NOT TO SCALE

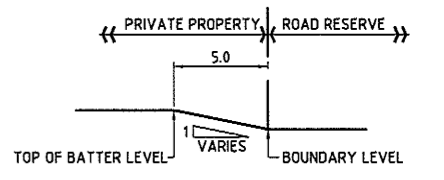

FRONT BATTER DETAIL
NOT TO SCALE

NOTE
 DESIGN LEVELS SHOWN INSIDE OF PARKS AND AT
 BOTTOM OF BATTERS IN PARKS WERE LOWERED
 BY 100mm FOR BULK EARTHWORKS TO ALLOW
 FOR TOPSOIL AND TURF BY LANDSCAPING
 CONTRACTOR

DATUM
 PM No.131651 LOCATED ON
 HERVEY RANGE ROAD (BOLT IN BITUMEN)
 RL 19.248m AHD

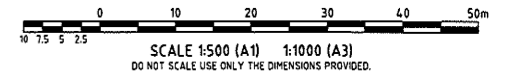

FOR CONTINUATION REFER DRAWING CT-1560-103

User: STRAITTON JACOBS Date: 17/11/2009 4:46:03 PM

A ORIGINAL ISSUE		S.J.J.	E.J.C.	9310	28.10.09
No.	Amendments	Drawn	Design	Appd	Certified
This drawing cannot be copied or reproduced in any form or used for any purpose other than that originally intended without the written permission of BMD Consulting Pty Ltd. © COPYRIGHT 2009					



BMD consulting

1st Floor,
 57 Mitchell Street North Ward QLD 4810
 PO Box 8008 Townsville MC QLD 4810
 P: 07 4750 7000 F: 07 4750 7077
 E: townsville@bmd.com.au
 www.bmd.com.au
 ABN 23 010 743 692

Civil Engineers • Structural Engineers • Project Managers • Water Servicing Co-ordinators
 brisbane • cairns • canberra • gladstone • gold coast • mackay • sydney • townsville

Client	URBEX PTY LTD	Datum	AHD
Project	KALYNDA CHASE STAGE 6B	PSM	131651
Title	EARTHWORKS MANAGEMENT LAYOUT PLAN (SHEET 1 OF 2)	RL	19.248
		AHD	
		AS CONSTRUCTED	
		Project No.	Drawing No.
		CT-1560-102	Rev A

