


FOR CONTINUATION REFER DWG CT1403-311

BRAZIER MOTTI PTY LTD. ACN 066 411 041
 595 FLINDERS ST. TOWNSVILLE, HEREBY CERTIFY THAT
 THIS DRAWING ACCURATELY AND CORRECTLY DESCRIBES
 AND RECORDS THE NATURE AND LOCATION OF THE WORKS
 DEPICTED BY ASTERISKS HEREON AS THEY HAVE BEEN
 CONSTRUCTED FOR SUBDIVISION

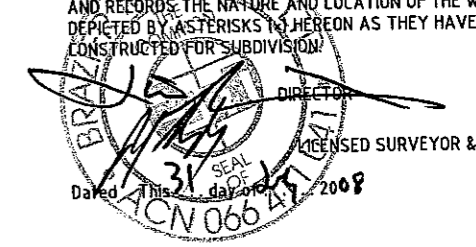

WATER LEGEND


- WATER MAIN
- 63 OD POLYETHYLENE LOOP MAIN
- FH FIRE HYDRANT
- SV SLUICE VALVE
- GV GATE VALVE
- TEE
- END CAP
- WATER SERVICE WITH ENVELOPER
- EXIST. WATER MAIN
- EXIST. WATER MAIN (POLY)

WATER NOTES

1. ALL WATER MAINS ARE LOCATED 12m ALIGNMENT OFFSET FROM PROPERTY BOUNDARIES UNLESS SHOWN OTHERWISE
2. THIS DRAWING HAS BEEN READ IN CONJUNCTION WITH CITY OF THURINGOWA STANDARD DRAWINGS (WATER).
3. ALL uPVC MAINS ARE SERIES 2, PN16 TO AS/NZS 1477 RUBBER RING JOINTED, WITH SOCKETED D.I.C.L. FITTINGS U.N.O.
4. CONNECTION TO EXISTING THURINGOWA COUNCIL WATER MAINS WERE CARRIED OUT BY THE CONTRACTOR UNDER COUNCIL SUPERVISION
5. CONNECTION TO EXISTING HQ WATER MAINS WERE CARRIED OUT BY HQ WATER AT THE CONTRACTOR'S EXPENSE.

DATUM

PM No.131651 LOCATED ON
 HERVEY RANGE ROAD (BOLT IN BITUMEN)
 RL 19.248m AHD

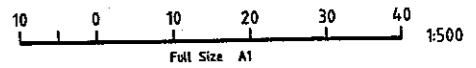

User: ALEXIS MORELLI File Name: JCT-1403 - 584x12-410 - WWTW Main Road (Lot 510) DWG.ctb Date: 22/07/2008 2:44:32 PM

No.	Amendments	By	Appd	Date	No.	Amendments	By	Appd	Date
A	ORIGINAL ISSUE	AM		22.07.08					



BMD CONSULTING
 Civil Engineers
 Structural Engineers
 & Project Managers
 ABN 23 010 743 992

Townsville Office: 57 Millwell Street, Townsville, P.O. Box 4688, Townsville, QLD 4810
 Phone: (07) 4150 7000, Fax: (07) 4750 7077, Email: info@bmd.com.au, www.bmd.com.au

Head Office - Brisbane: 107/3893 1511
 Sydney Office: (02) 9898 5400
 Cairns Office: (07) 4035 1544

Design	AM
Drawn	JL
Checked	JL
Original Approved By:	<i>[Signature]</i>
RPEQ No.	6948
Date	JULY 2008

Client	URBEX PTY LTD	
Project	KALYNDA STAGE 5C	
Title	WATER RETICULATION PLAN	AS CONSTRUCTED
	SHEET 1 OF 2	Drawing No. CT1403-310 Rev A

THIS DRAWING CANNOT BE COPIED OR REPRODUCED IN ANY FORM OR USED FOR ANY OTHER PURPOSE OTHER THAN THAT ORIGINALLY INTENDED WITHOUT THE WRITTEN PERMISSION OF BMD CONSULTING PTY LTD.

WATER LEGEND

- WATER MAIN
- 63 OD POLYETHYLENE LOOP MAIN
- FH FIRE HYDRANT
- SV SLUICE VALVE
- GV GATE VALVE
- TEE
- END CAP
- WATER SERVICE WITH ENVELOPER
- EXIST. WATER MAIN
- EXIST. WATER MAIN (POLY)

WATER NOTES



1. ALL WATER MAINS ARE LOCATED 1.2m ALIGNMENT OFFSET FROM PROPERTY BOUNDARIES UNLESS SHOWN OTHERWISE
2. THIS DRAWING HAS BEEN READ IN CONJUNCTION WITH CITY OF THURINGOWA STANDARD DRAWINGS (WATER).
3. ALL uPVC MAINS ARE SERIES 2, PN16 TO AS/NZS 1477 RUBBER RING JOINTED, WITH SOCKETED D.I.C.L. FITTINGS U.N.O.
4. CONNECTION TO EXISTING THURINGOWA COUNCIL WATER MAINS WERE CARRIED OUT BY THE CONTRACTOR UNDER COUNCIL SUPERVISION
5. CONNECTION TO EXISTING NQ WATER MAINS WERE CARRIED OUT BY NQ WATER AT THE CONTRACTOR'S EXPENSE.

DATUM


PM No.131651 LOCATED ON HERVEY RANGE ROAD (BOLT IN BITUMEN) RL 19.248m AHD



BRAZIER MOTTI PTY LTD. ACN 066 411 041
 595 FLINDERS ST. TOWNSVILLE. HEREBY CERTIFY THAT THIS DRAWING ACCURATELY AND CORRECTLY DESCRIBES AND RECORDS THE NATURE AND LOCATION OF THE WORKS DEPICTED BY ASTERISKS (*) HEREON AS THEY HAVE BEEN CONSTRUCTED FOR SUBDIVISION.
 DIRECTOR
 LICENSED SURVEYOR & DIRECTOR
 Dated This day of July 2008
 ACN 066 411 041

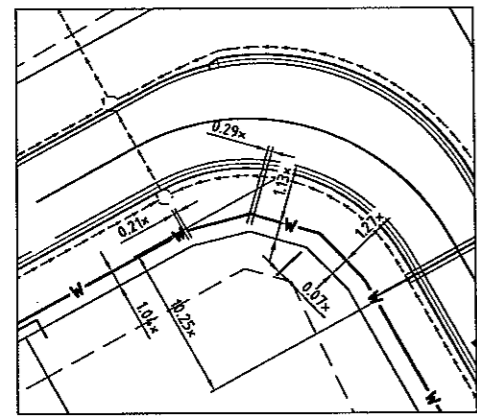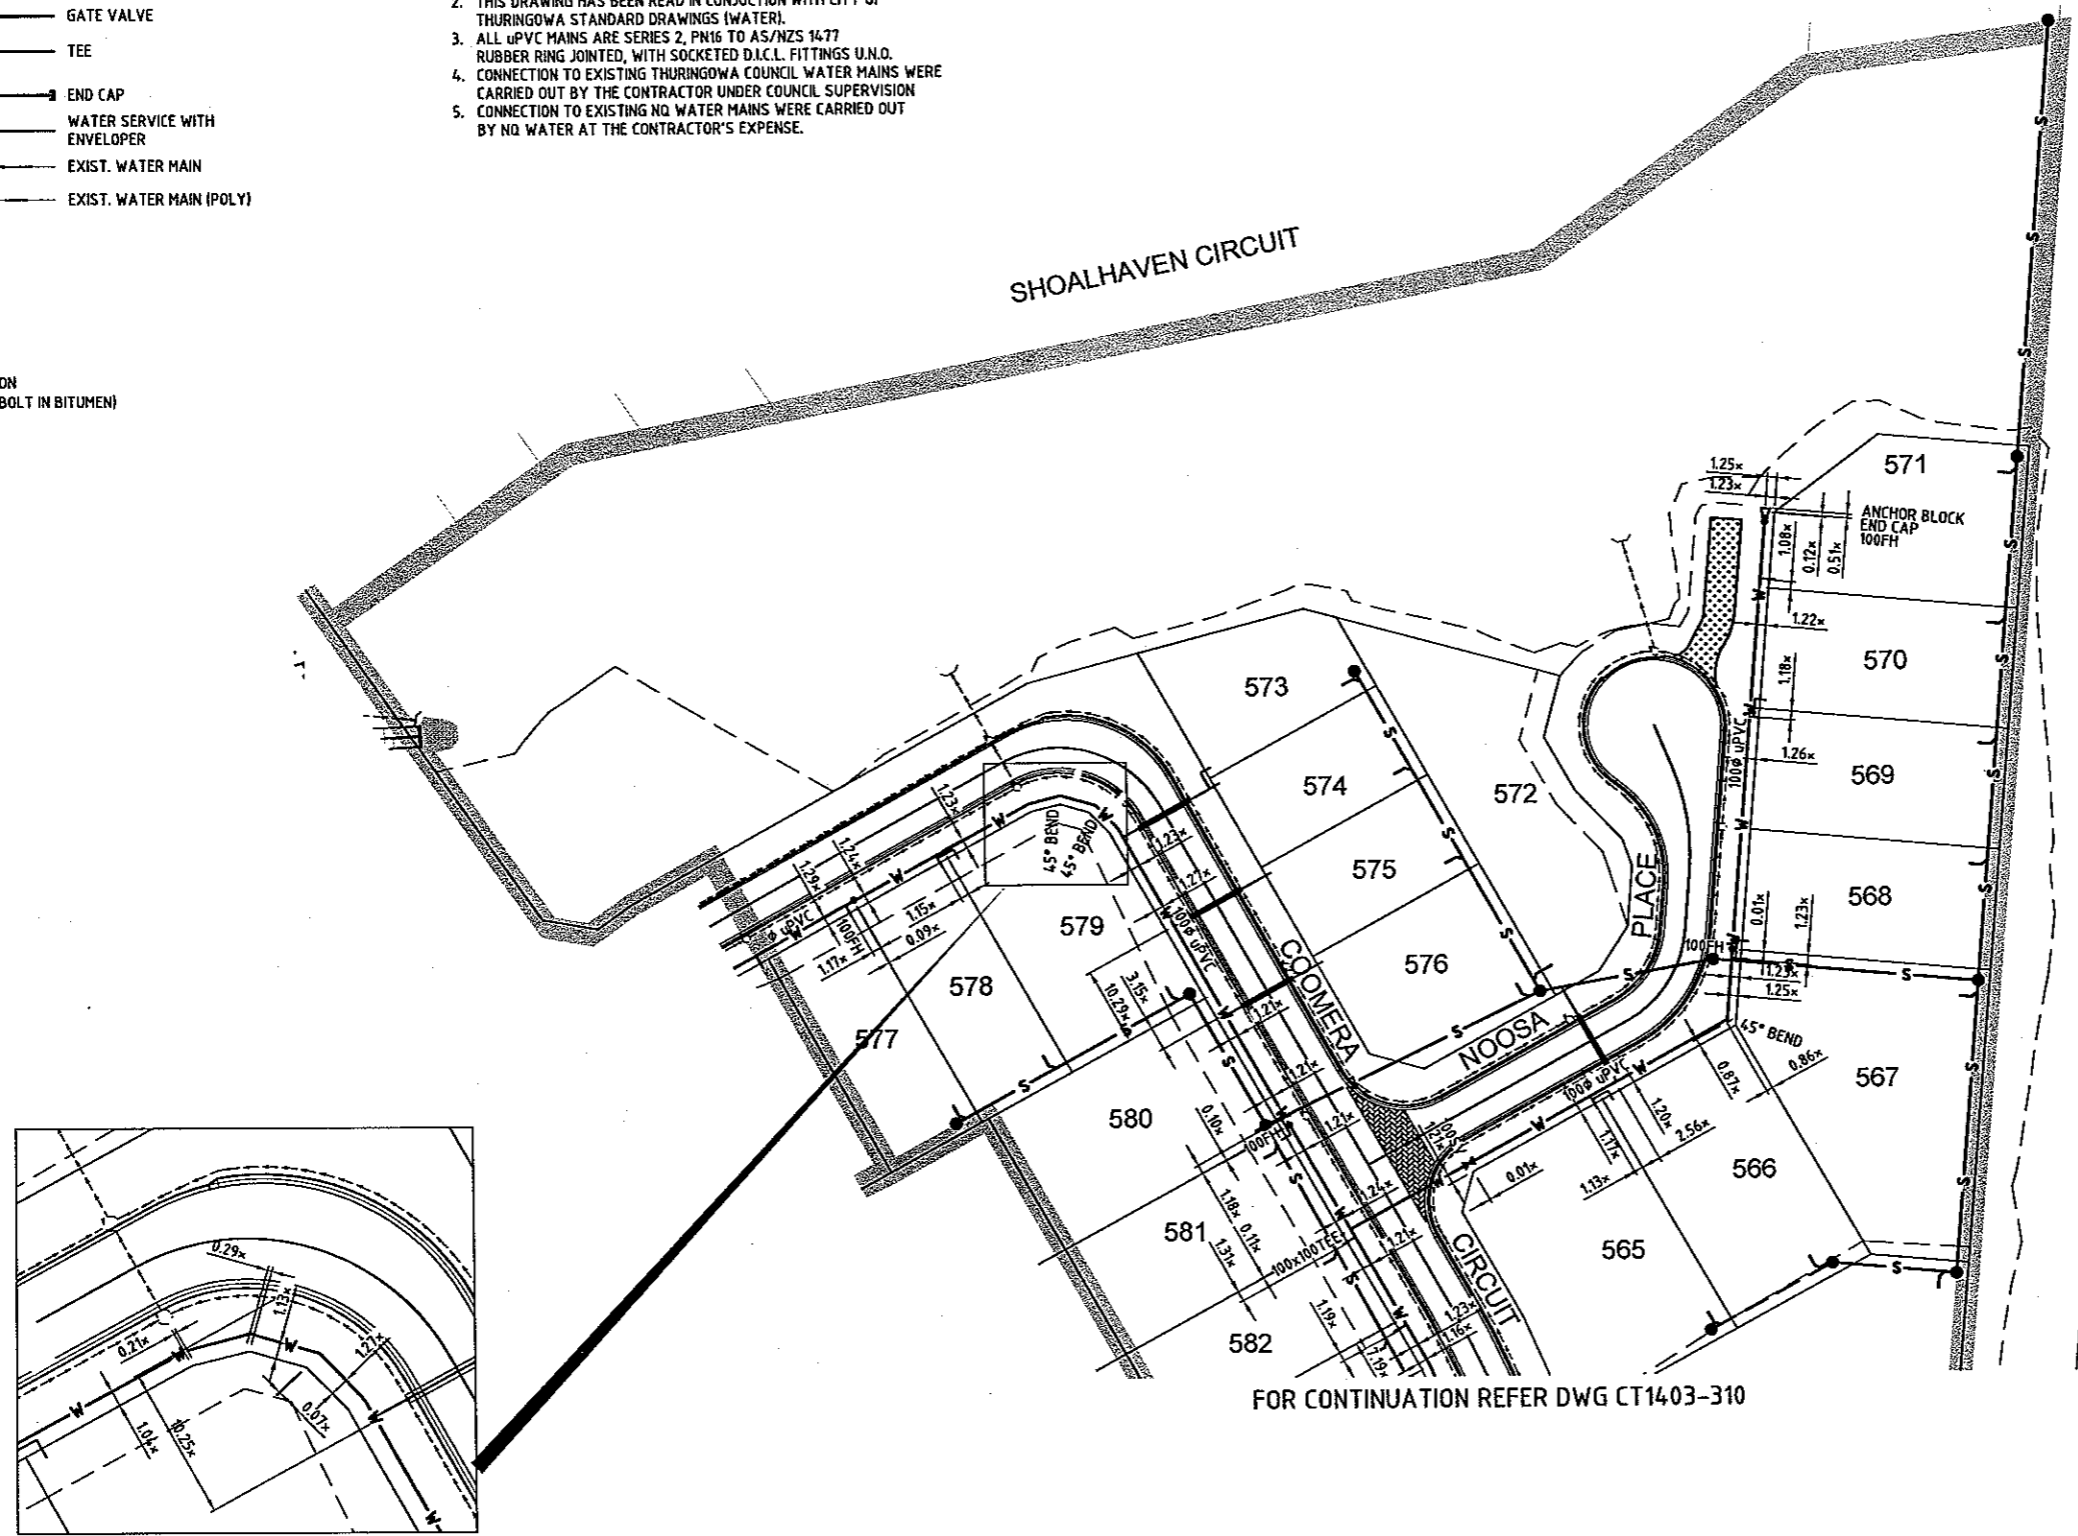

FOR CONTINUATION REFER DWG CT1403-310

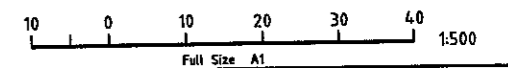

User: ALEXIS MORELLI File Name: ACT-1403 - 1500.ctb Path: \\bms\projects\1403.ctb

No.	Amendments	By	Appd	Date	No.	Amendments	By	Appd	Date
A	ORIGINAL ISSUE	AM		22.07.08					



BMD CONSULTING
 Civil Engineers, Structural Engineers & Project Managers
 ABN 23 010 743 602

Townsville Office: 57 Mitchell Street, Townsville, P.O. Box 6008, Townsville, QLD 4810. Ph: (07) 4756 7000, Fax: (07) 4756 7077, Email: bmd@bmdconsulting.com.au, www.bmd.com.au

Head Office - Brisbane: Ph: (07) 3893 1511
 Sydney Office: Ph: (02) 9898 5400
 Cairns Office: Ph: (07) 4035 1544

Design	AM
Drawn	AM
Checked	JL
Original Approved By:	[Signature]
RPEQ No.	1948
Date	JULY 2008

URBEX PTY LTD
KALYNDA STAGE 5C
AS CONSTRUCTED
WATER RETICULATION PLAN
SHEET 2 OF 2
 Drawing No. CT1403-311 Rev A

THIS DRAWING CANNOT BE COPIED OR REPRODUCED IN ANY FORM OR USED FOR ANY OTHER PURPOSE OTHER THAN THAT ORIGINALLY INTENDED WITHOUT THE WRITTEN PERMISSION OF BMD CONSULTING PTY LTD.