


**REAR BATTER DETAIL**  
NOT TO SCALE

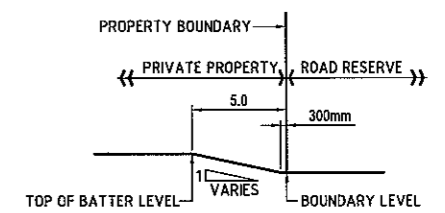


**FRONT BATTER DETAIL**  
NOT TO SCALE


**NOTES**

- LEVELS SHOWN INSIDE OF PARKS AND AT BOTTOM OF BATTERS IN PARKS WERE LOWERED BY 100mm FOR BULK EARTHWORKS TO ALLOW FOR TOPSOIL AND TURF BY LANDSCAPING CONTRACTOR
- ALL WORKS IN PARK HAVE BEEN VERIFIED BY SUPERINTENDENT PRIOR TO COMMENCING WORKS
- ALL PARK BATTER TREATMENTS ADJACENT TO EXISTING GULLY ARE FINISHED WITH A SLOPE OF 1 ON 3. FINAL BATTER TREATMENTS AS PER LANDSCAPE ARCHITECTS DETAIL.

BRAZIER MOTTI PTY LTD. ACN 066 411 041  
595 FLINDERS ST. TOWNSVILLE, HEREBY CERTIFY THAT THIS DRAWING ACCURATELY AND CORRECTLY DESCRIBES AND RECORDS THE NATURE AND LOCATION OF THE WORKS DEPICTED BY ASTERISKS (\*) HEREON AS THEY HAVE BEEN CONSTRUCTED FOR SUBDIVISION.

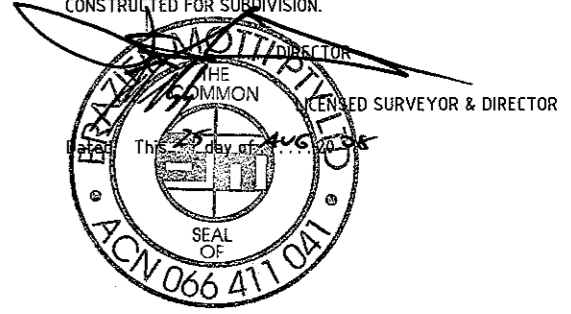

**DATUM**  
PM No.131651 LOCATED ON  
HERVEY RANGE ROAD (BOLT IN BITUMEN)  
RL 19.248m AHD

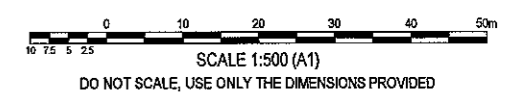

User: ALEXIS MIBELLI File Name: J:\CT-1371-1384-1385\CT-1371-1384-1385.dwg Stage: 6/Drawings/As Constructed/CT-1371-1384-1385.dwg Plot Date: 25/08/2008 2:52:08 AM

No.	Amendments	By	Appd	Date	No.	Amendments	By	Appd	Date
A	ORIGINAL ISSUE	AM		25.08.08					



**BMD CONSULTING**  
Civil Engineers  
Structural Engineers  
& Project Managers  
ASB 23 010 743 892

Townsville Office  
57 Mitchell Street  
Townsville  
P.O. Box 6008  
Townsville MC, QLD 4810  
Ph: (07) 4750 7000  
Fax: (07) 4750 7077  
Email: bmd@bmdconsulting.com.au  
www.bmdconsulting.com.au

Head Office - Brisbane  
Ph: (07) 3853 1511  
Sydney Office  
Ph: (02) 9698 5400  
Cairns Office  
Ph: (07) 4035 1544

Design	AM
Drawn	JL
Checked	JL
Original Approved By:	<i>[Signature]</i>
RPEQ No.	5848
Date	AUG 08
Datum	A.H.D.

Client: **URBEX PTY. LTD.**

Project: **KALYNDA CHASE STAGE 6A AS CONSTRUCTED**

Title: **EARTHWORKS LAYOUT PLAN**

AS CONSTRUCTED

Drawing No. **CT1371-103**

Rev **A**