

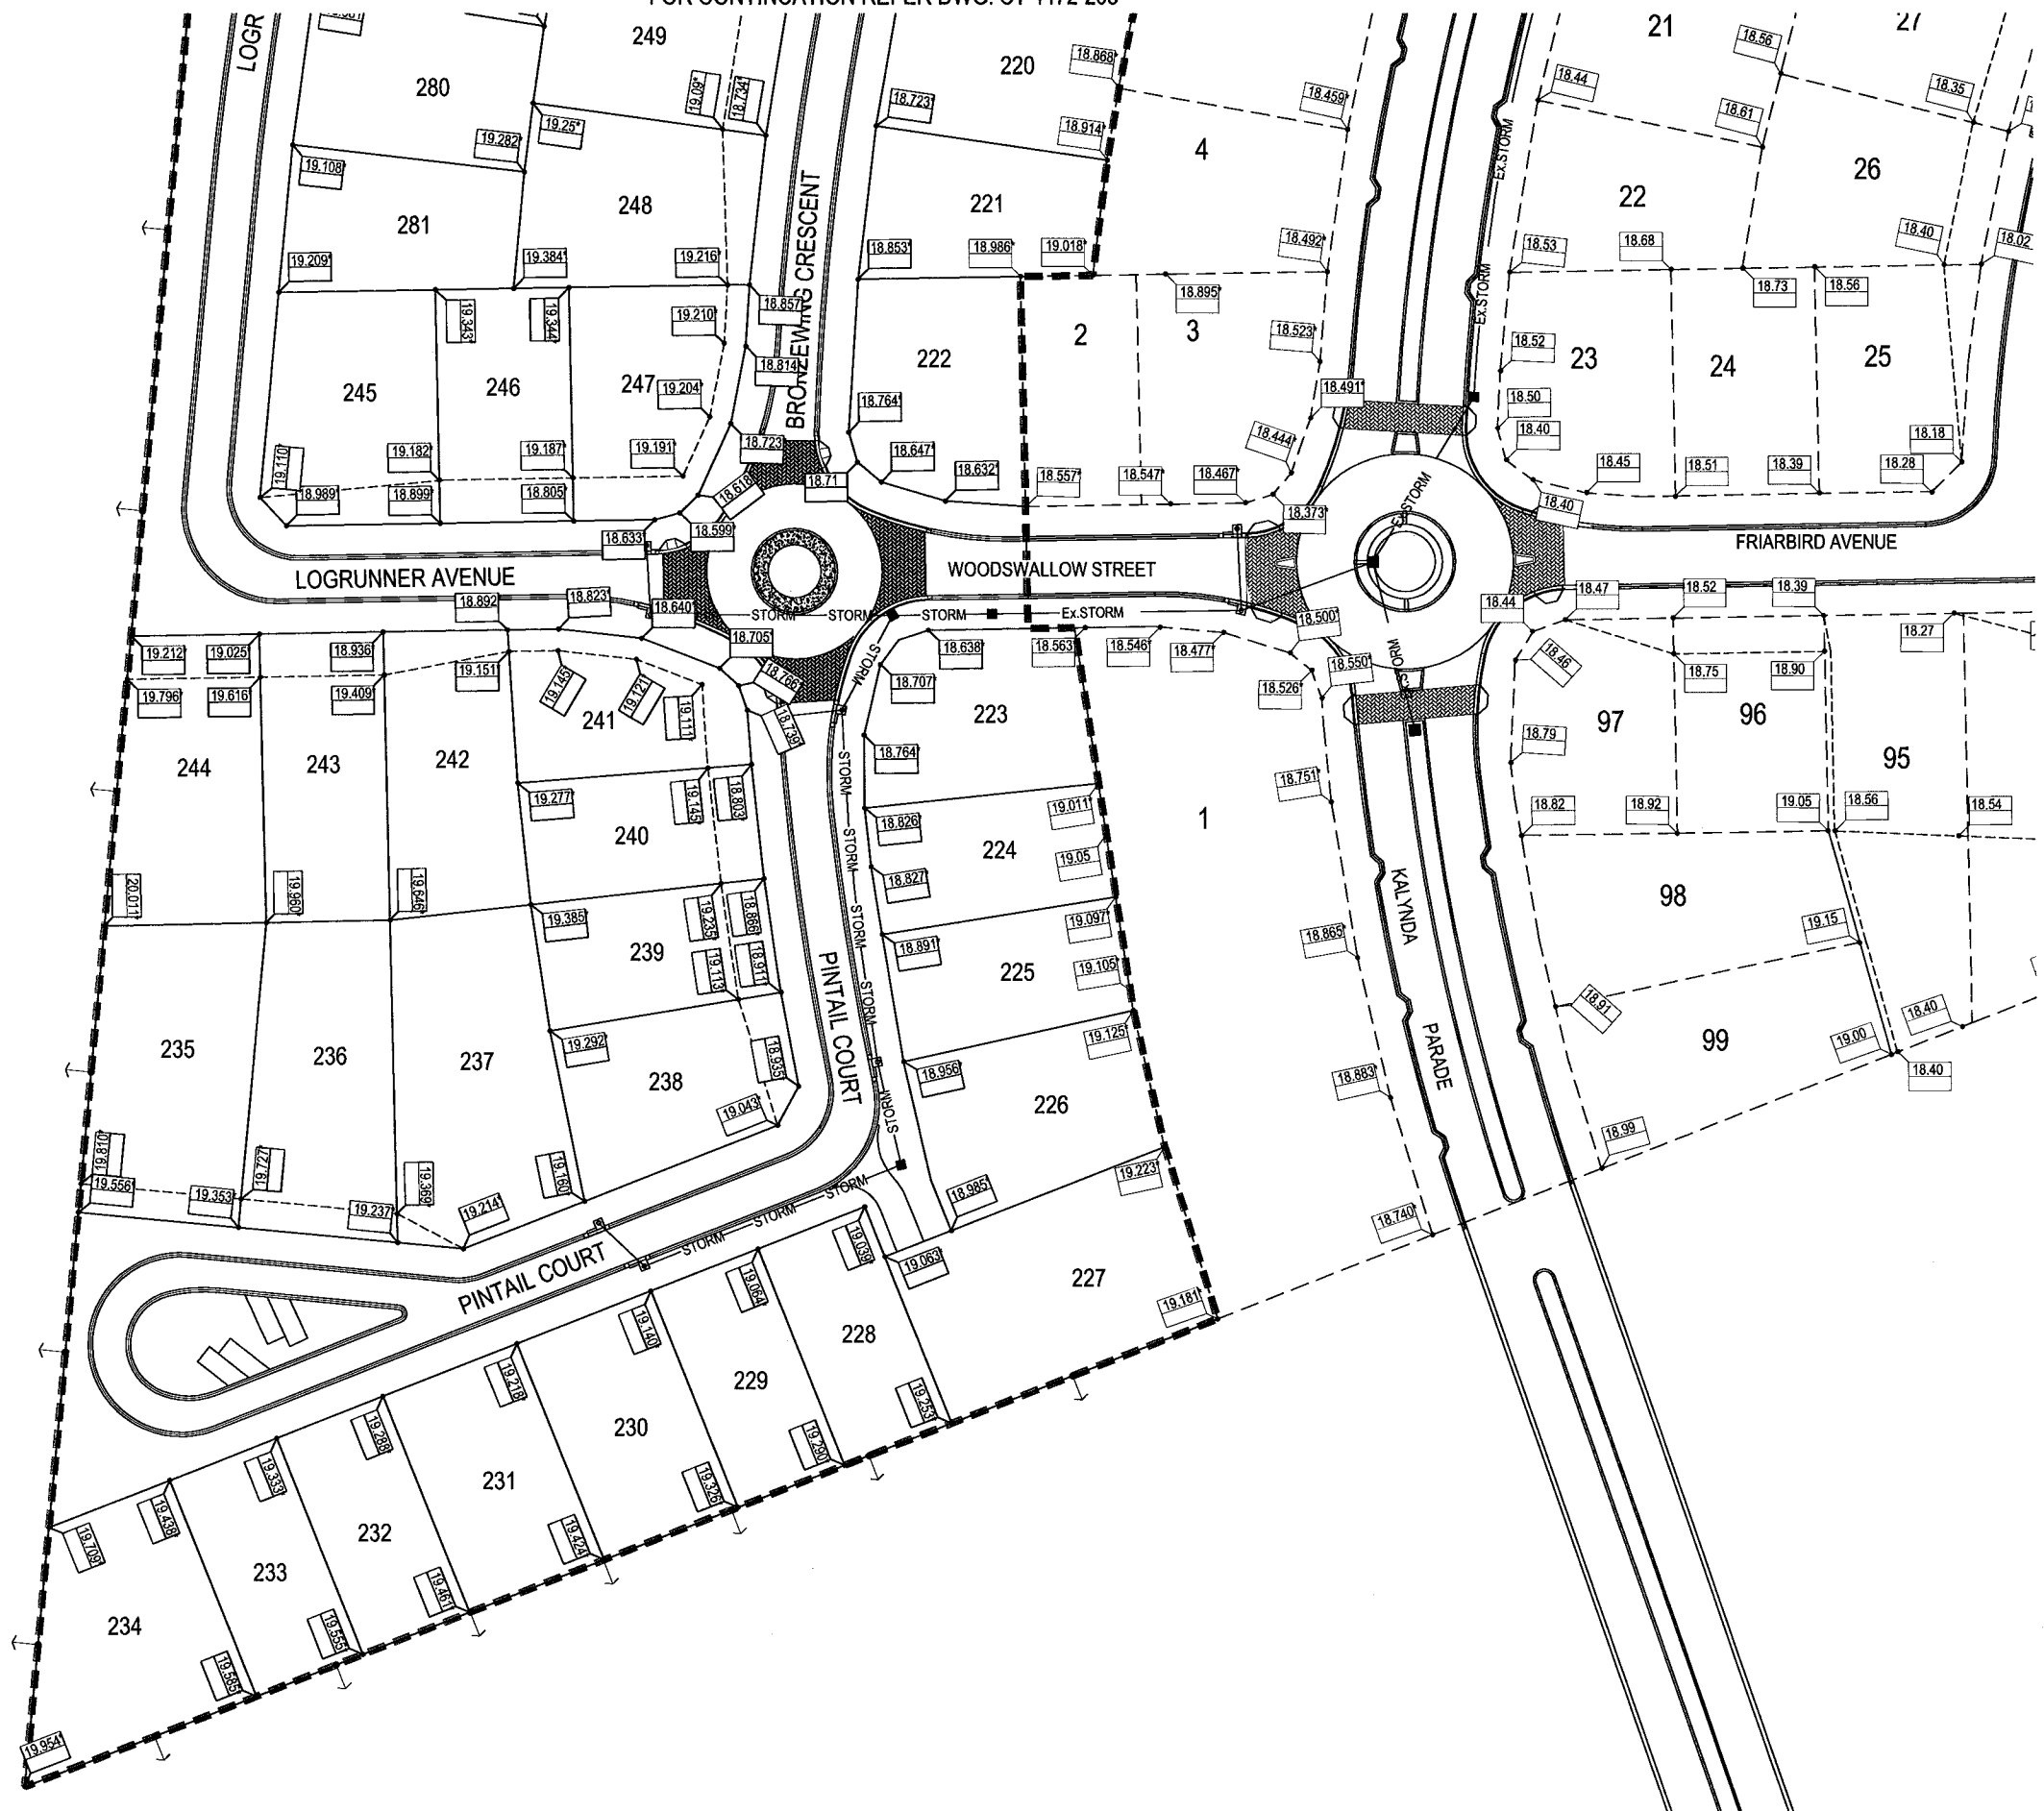


FOR CONTINUATION REFER DWG. CT-1172-203

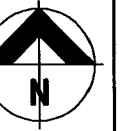


**LEGEND**

- DENOTES BATTER TO EXIST. AT 1 IN 6 SLOPE
- AS CONSTRUCTED SURFACE LEVEL
- NATURAL SURFACE CONTOURS
- LIMIT OF WORKS - STAGE 3

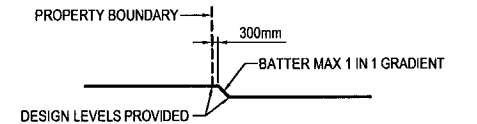


**REAR BATTER DETAIL**  
NOT TO SCALE

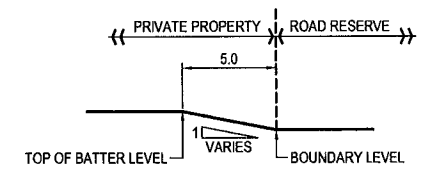


**FRONT BATTER DETAIL**  
NOT TO SCALE

BRAZIER MOTTI PTY LTD. ACN 066 411 041  
595 FLINDERS ST. TOWNSVILLE. HEREBY CERTIFY THAT THIS DRAWING ACCURATELY AND CORRECTLY DESCRIBES AND RECORDS THE NATURE AND LOCATION OF THE WORKS DEPICTED BY THIS PLAN HEREON AS THEY HAVE BEEN CONSTRUCTED TO THE DIVISION.

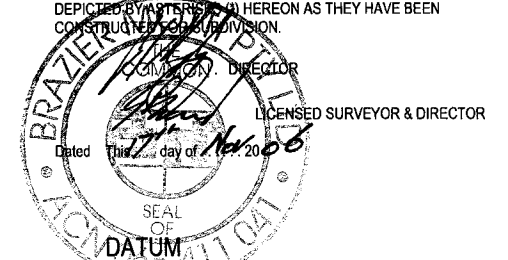

PM No. 131661 LOCATED ON HERVEY RANGE ROAD (BOLT IN BITUMEN) RL 19.248

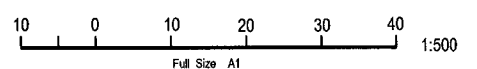

No.	Amendments	By	Appd	Date	No.	Amendments	By	Appd	Date
A	ORIGINAL ISSUE	CH		16.11.06					

THIS DRAWING CANNOT BE COPIED OR REPRODUCED IN ANY FORM OR USED FOR ANY OTHER PURPOSE OTHER THAN THAT ORIGINALLY INTENDED WITHOUT THE WRITTEN PERMISSION OF BMD CONSULTING PTY LTD

**BMD CONSULTING**  
Civil Engineers  
Structural Engineers  
Project Managers  
ABN 23 010 743 892


**urbex**

Townsville Office: 57 Mitchell Street, Townsville, P.O. Box 6008, Townsville MC, QLD 4810  
Ph: (07) 4750 7000, Fax: (07) 4750 7077, email: bmd@bmd.com.au, www.bmd.com.au


Head Office - Brisbane: Ph: (07) 3593 1511, Fax: (07) 4035 1544  
Cairns Office: Ph: (07) 4035 1544, Fax: (07) 4035 1544

Design	CH	Client	URBEX Pty Ltd
Drawn	CH	Project	KALYMBA CHASE - STAGE 3
Checked	JAM	Title	"AS CONSTRUCTED" EARTHWORKS LAYOUT PLAN Sheet 1 of 5
Original Approved By:	MKB	AS CONSTRUCTED	Drawing No. CT-1172-202
RPEQ No.	5555	Rev	A
Date	NOV '06		
Datum	A.H.D.		


FOR CONTINUATION REFER DWG. CT-1172-204

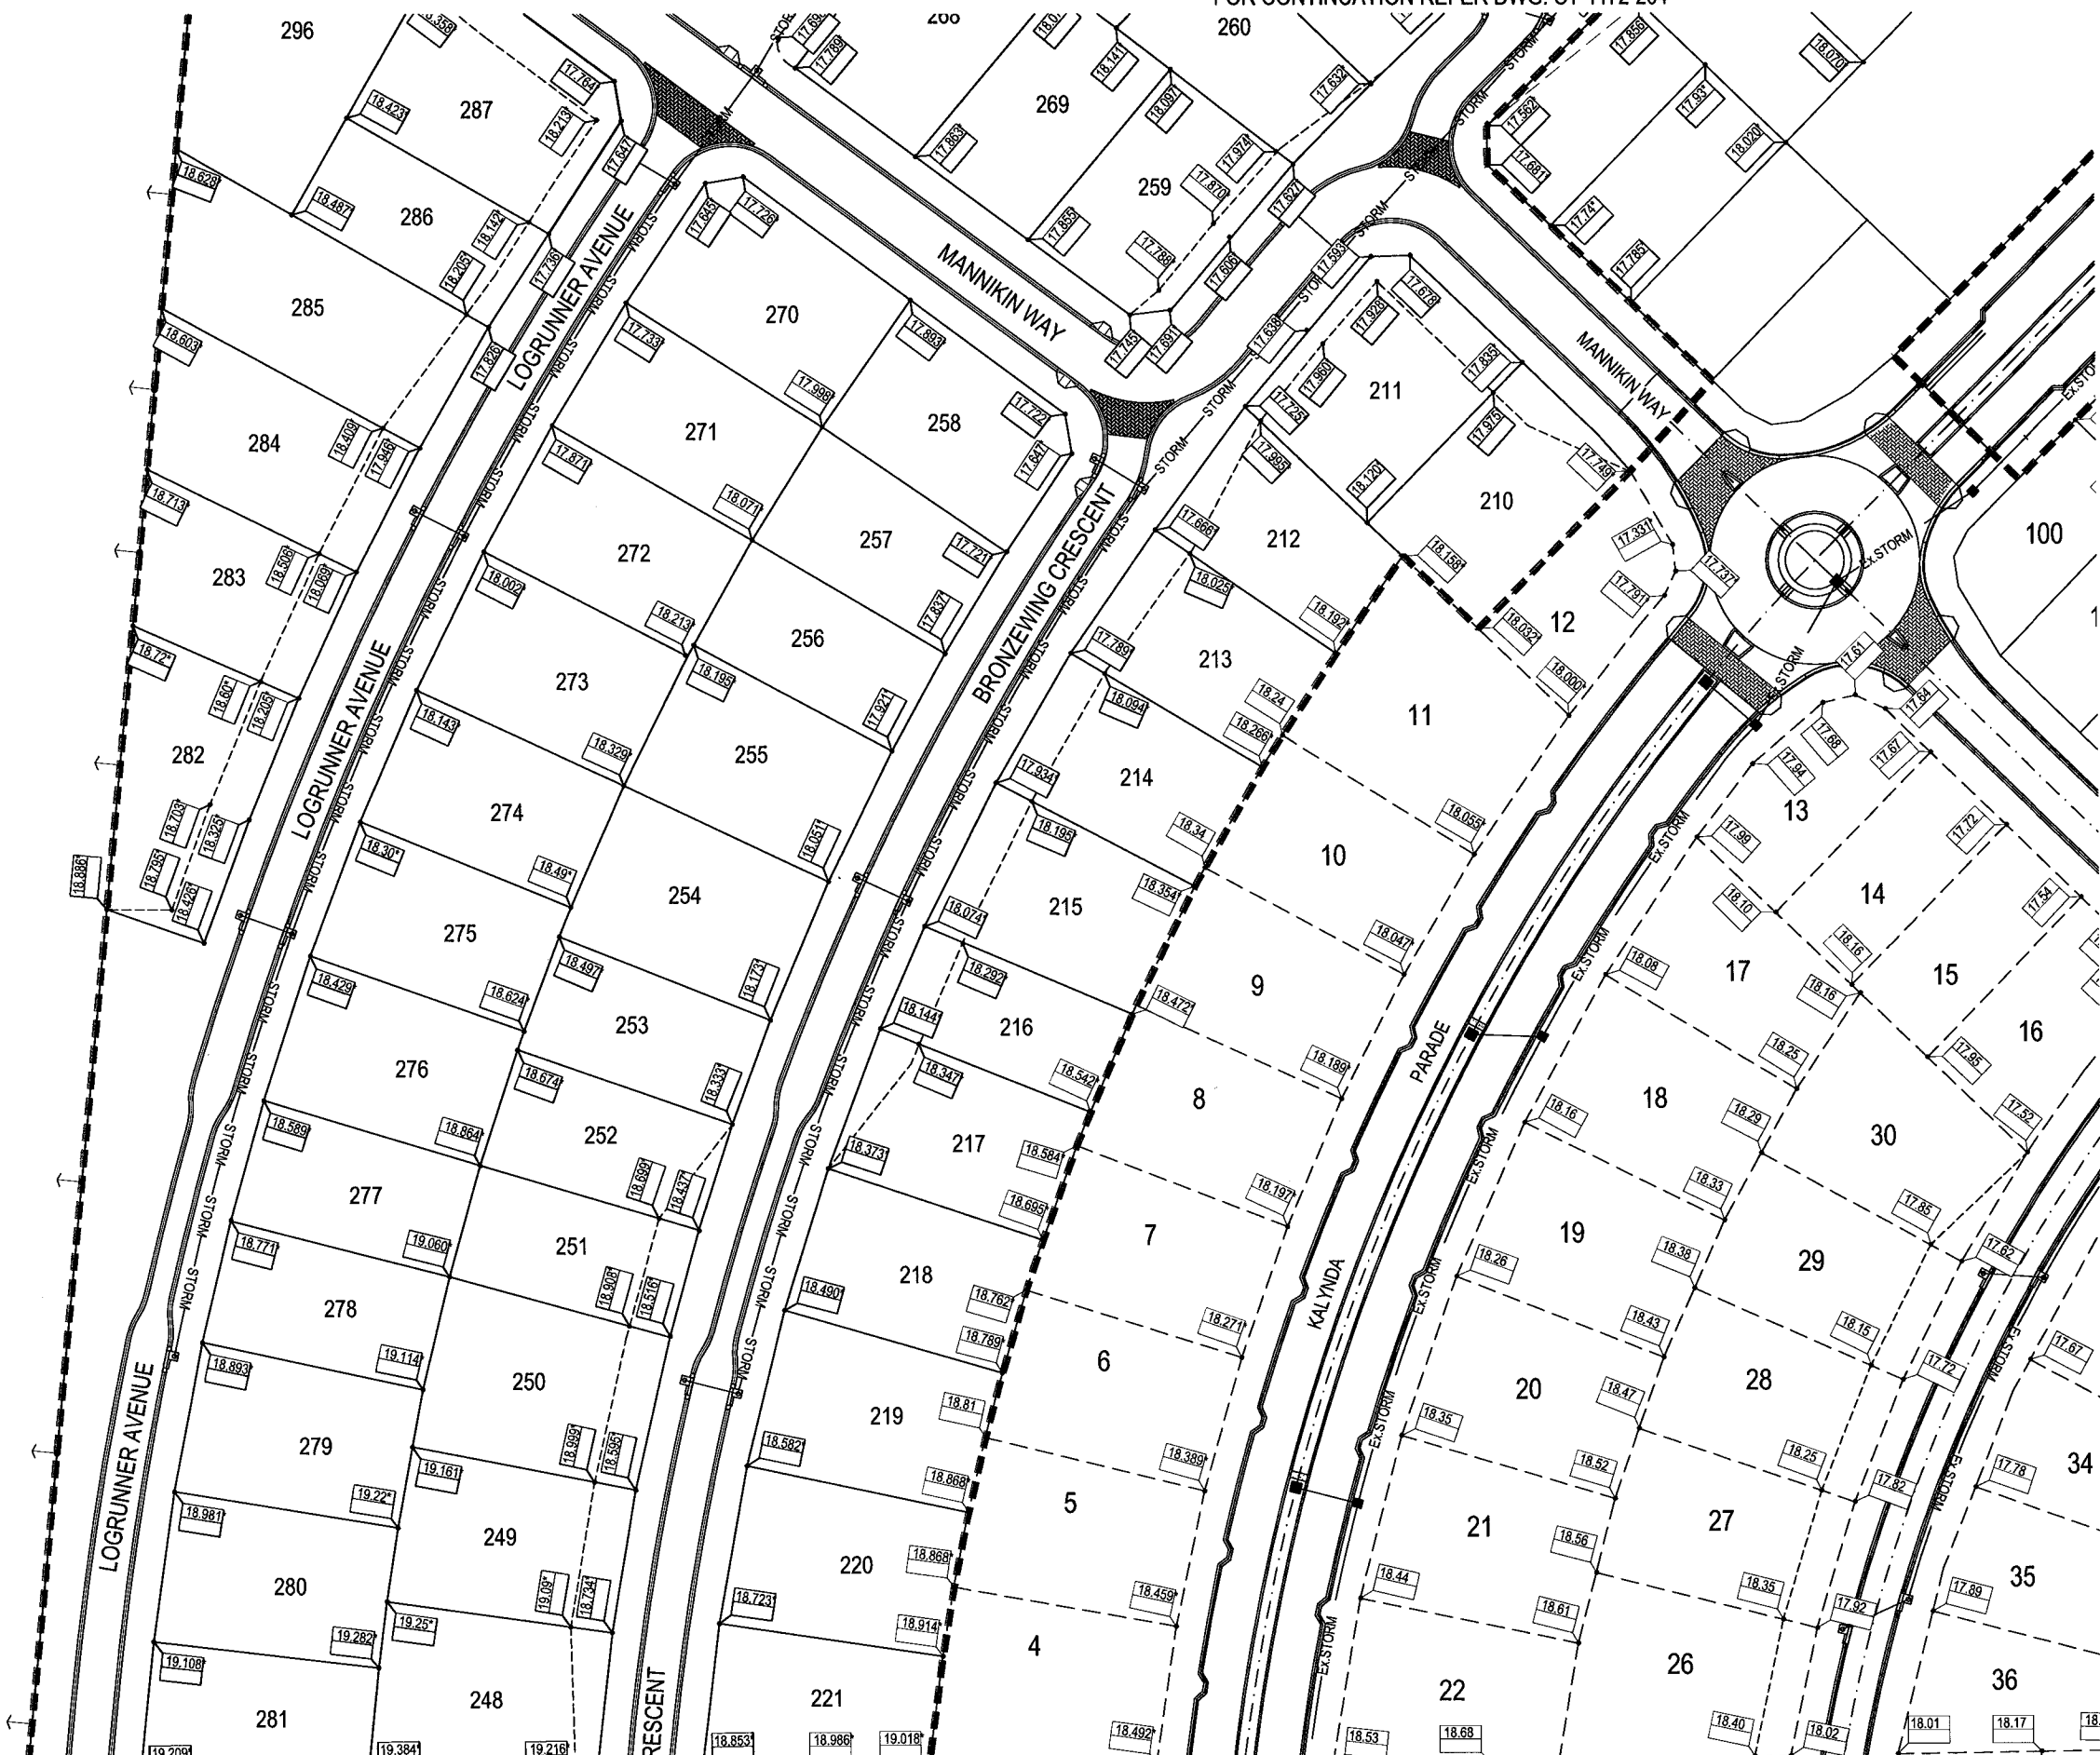

- LEGEND**
- ALLOTMENT FILL
  - DENOTES BATTER TO EXIST AT 1 IN 6 SLOPE
  - AS CONSTRUCTED SURFACE LEVEL
  - NATURAL SURFACE CONTOURS
  - LIMIT OF WORKS - STAGE 3
  - CONSTRUCT CUT OFF DRAIN

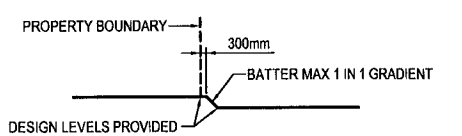


**REAR BATTER DETAIL**  
NOT TO SCALE

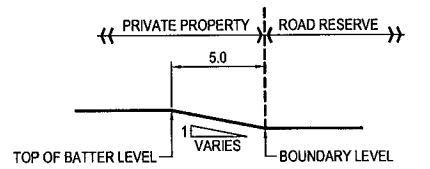


**FRONT BATTER DETAIL**  
NOT TO SCALE

BRAZIER MOTTI PTY LTD. ACN 066 411 041  
595 FLINDERS ST. TOWNSVILLE. HEREBY CERTIFY THAT THIS DRAWING ACCURATELY AND CORRECTLY DESCRIBES AND RECORDS THE NATURE AND LOCATION OF THE WORKS DENOTED BY ASTERISKS (\*) HEREON AS THEY HAVE BEEN CONSTRUCTED FOR THIS DIVISION.

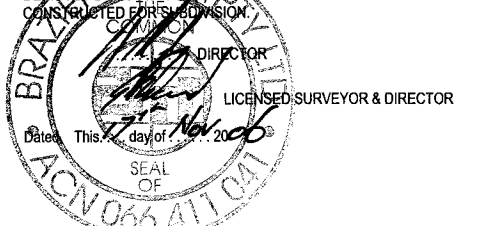

**DATUM**  
PM No.131651 LOCATED ON HERVEY RANGE ROAD (BOLT IN BITUMEN) RL 19.248

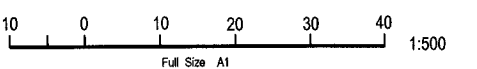

FOR CONTINUATION REFER DWG. CT-1172-2020

No.	Amendments	By	Appd	Date	No.	Amendments	By	Appd	Date
A	ORIGINAL ISSUE	CH		16.11.06					

THIS DRAWING CANNOT BE COPIED OR REPRODUCED IN ANY FORM OR USED FOR ANY OTHER PURPOSE OTHER THAN THAT ORIGINALLY INTENDED WITHOUT THE WRITTEN PERMISSION OF BMD CONSULTING PTY LTD.

Civil Engineers  
Structural Engineers  
Project Managers

**BMD**  
CONSULTING

Townsville Office  
ST Michael Street,  
Townsville  
P.O. Box 9008  
Townsville MC, QLD 4810


Ph: (07) 4750 7000  
Fax: (07) 4750 7077  
email: bmd@bmd.com.au  
www.bmd.com.au

Head Office - Brisbane  
Ph: (07) 3593 1511  
Sydney Office  
Ph: (02) 9588 5400


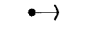
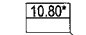
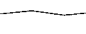


Calms Office  
Ph: (07) 4035 1544


Design	CH	Client	URBEX Pty Ltd
Drawn	JAM	Project	KALYNDA CHASE - STAGE 3
Checked	MKB	Title	"AS CONSTRUCTED" EARTHWORKS LAYOUT PLAN Sheet 2 of 5
Original Approved By:			
RPEQ No.	5555		
Date	NOV '06		
Datum	A.H.D.		

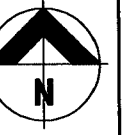**AS CONSTRUCTED**  
Drawing No. CT-1172-203 Rev A




**LEGEND**

-  ALLOTMENT FILL
-  DENOTES BATTER TO EXIST. AT 1 IN 6 SLOPE
-  AS CONSTRUCTED SURFACE LEVEL
-  NATURAL SURFACE CONTOURS
-  LIMIT OF WORKS - STAGE 3
-  CONSTRUCT CUT OFF DRAIN

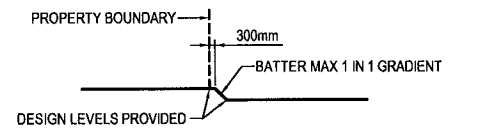


**REAR BATTER DETAIL**  
NOT TO SCALE

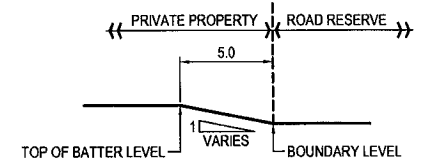


**FRONT BATTER DETAIL**  
NOT TO SCALE

BRAZIER MOTTI PTY LTD. ACN 066 411 041  
595 FLINDERS ST. TOWNSVILLE, HEREBY CERTIFY THAT THIS DRAWING ACCURATELY AND CORRECTLY DESCRIBES AND RECORDS THE NATURE AND LOCATION OF THE WORKS DEPICTED BY ASTERISKS (\*) HEREON AS THEY HAVE BEEN CONSTRUCTED FOR SUBDIVISION

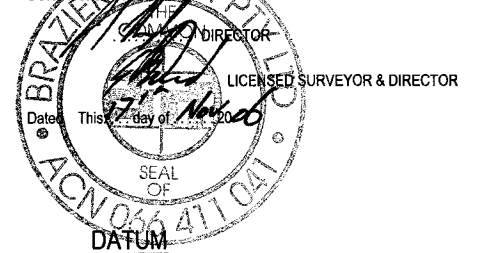

PM No.131651 LOCATED ON HERVEY RANGE ROAD (BOLT IN BITUMEN) RL 19.248

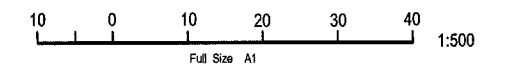

FOR CONTINUATION REFER DWG. CT-1172-203



No.	Amendments	By	Appd	Date	No.	Amendments	By	Appd	Date
A	ORIGINAL ISSUE	CH		16.11.06					


THIS DRAWING CANNOT BE COPIED OR REPRODUCED IN ANY FORM OR USED FOR ANY OTHER PURPOSE OTHER THAN THAT ORIGINALLY INTENDED WITHOUT THE WRITTEN PERMISSION OF BMD CONSULTING PTY LTD.

**URBEX**

Civil Engineers  
Structural Engineers  
Project Managers  
ABN 23 010 743 992

Townsville Office  
57 Mitchell Street  
Townsville  
P.O. Box 6008  
Townsville MC, QLD 4810

Ph: (07) 4750 7000  
Fax: (07) 4750 7017  
email: bmd.com.au



**BMD**  
CONSULTING

Design	CH	Client	<b>URBEX Pty Ltd</b>
Drawn	JAM	Project	<b>KALYND A CHASE - STAGE 3</b>
Checked	MKB	Title	<b>"AS CONSTRUCTED" EARTHWORKS LAYOUT PLAN Sheet 3 of 5</b>
Original Approved By:			
RPEQ No.	5555		
Date	NOV '06		
Datum	A.H.D.		

**AS CONSTRUCTED**


Drawing No. **CT-1172-204** Rev **A**

FOR CONTINUATION REFER DWG. CT-1172-206




**LEGEND**

- ALLOTMENT FILL
- DENOTES BATTER TO EXIST. AT 1 IN 8 SLOPE
- AS CONSTRUCTED SURFACE LEVEL
- NATURAL SURFACE CONTOURS
- LIMIT OF WORKS - STAGE 3
- CONSTRUCT CUT OFF DRAIN

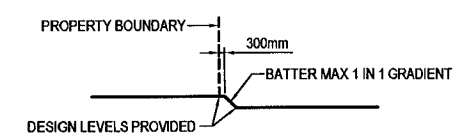

**REAR BATTER DETAIL**  
NOT TO SCALE

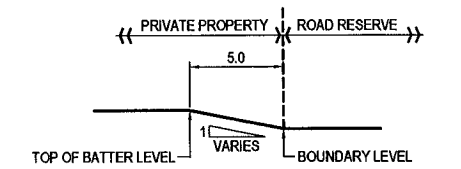

**FRONT BATTER DETAIL**  
NOT TO SCALE

BRAZIER MOTTI PTY LTD. ACN 066 411 041  
595 FLINDERS ST. TOWNSVILLE. HEREBY CERTIFY THAT THIS DRAWING ACCURATELY AND CORRECTLY DESCRIBES AND RECORDS THE NATURE AND LOCATION OF THE WORKS DEPICTED BY ASTERISKS (\*) HEREON AS THEY HAVE BEEN CONSTRUCTED FOR SUBMISSION.

*[Signature]* DIRECTOR  
LICENSED SURVEYOR & DIRECTOR  
Dated This 11. day of Dec 2006

**DATUM**  
PM No. 131651 LOCATED ON  
HERVEY RANGE ROAD (BOLT IN BITUMEN)  
RL 19.248

No.	Amendments	By	Appd	Date	No.	Amendments	By	Appd	Date
B	TEXT IN PARK REMOVED	JAM	[Signature]	06.12.06					
A	ORIGINAL ISSUE	CH	JL	16.11.06					

THIS DRAWING CANNOT BE COPIED OR REPRODUCED IN ANY FORM OR USED FOR ANY OTHER PURPOSE OTHER THAN THAT ORIGINALLY INTENDED WITHOUT THE WRITTEN PERMISSION OF BMD CONSULTING PTY LTD.

Civil Engineers  
Structural Engineers  
Project Managers

**BMD**  
CONSULTING

Townsville Office: 57 Michael Street, Townsville  
P.O. Box 9008, Townsville MC, QLD 4810  
Ph: (07) 4750 7000, Fax: (07) 4750 7077, email: bmdcon@bmd.com.au, www.bmd.com.au

Head Office - Brisbane  
Ph: (07) 3965 1611  
Sydney Office  
Ph: (02) 9558 5400

Calma Office  
Ph: (07) 4036 1544

Client: **URBEX Pty Ltd**

Project: **KALYNDA CHASE - STAGE 3**


Title: **"AS CONSTRUCTED" EARTHWORKS LAYOUT PLAN Sheet 4 of 5**

Design: CH  
Drawn: CH  
Checked: JAM  
Original Approved By: JL  
RPEQ No.: 5948  
Date: NOV '06  
Datum: A.H.D.







**AS CONSTRUCTED**

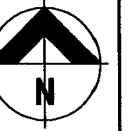
Drawing No. **CT-1172-205**

Rev **B**

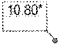


**LEGEND**

-  ALLOTMENT FILL
-  DENOTES BATTER TO EXIST. AT 1 IN 6 SLOPE
-  AS CONSTRUCTED SURFACE LEVEL
-  NATURAL SURFACE CONTOURS
-  LIMIT OF WORKS - STAGE 3
-  CONSTRUCT CUT OFF DRAIN

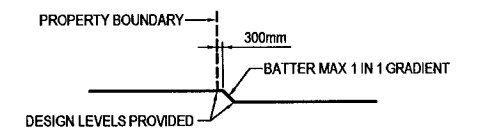

**REAR BATTER DETAIL**  
NOT TO SCALE

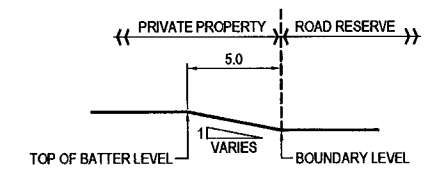

**FRONT BATTER DETAIL**  
NOT TO SCALE


BRAZIER MOTTI PTY LTD. ACN 068 411 041  
595 FLINDERS ST. TOWNSVILLE, HEREBY CERTIFY THAT THIS DRAWING ACCURATELY AND CORRECTLY DESCRIBES AND RECORDS THE NATURE AND LOCATION OF THE WORKS DEPICTED BY ASTERISKS (\*) HEREON AS THEY HAVE BEEN CONSTRUCTED FOR SUBDIVISION.

*[Signature]*  
DIRECTOR  
LICENSED SURVEYOR & DIRECTOR

Dated This 11<sup>th</sup> day of Dec: 2006



**DATUM**  
PM No. 131651 LOCATED ON  
HERVEY RANGE ROAD (BOLT IN BITUMEN)  
RL 19.248

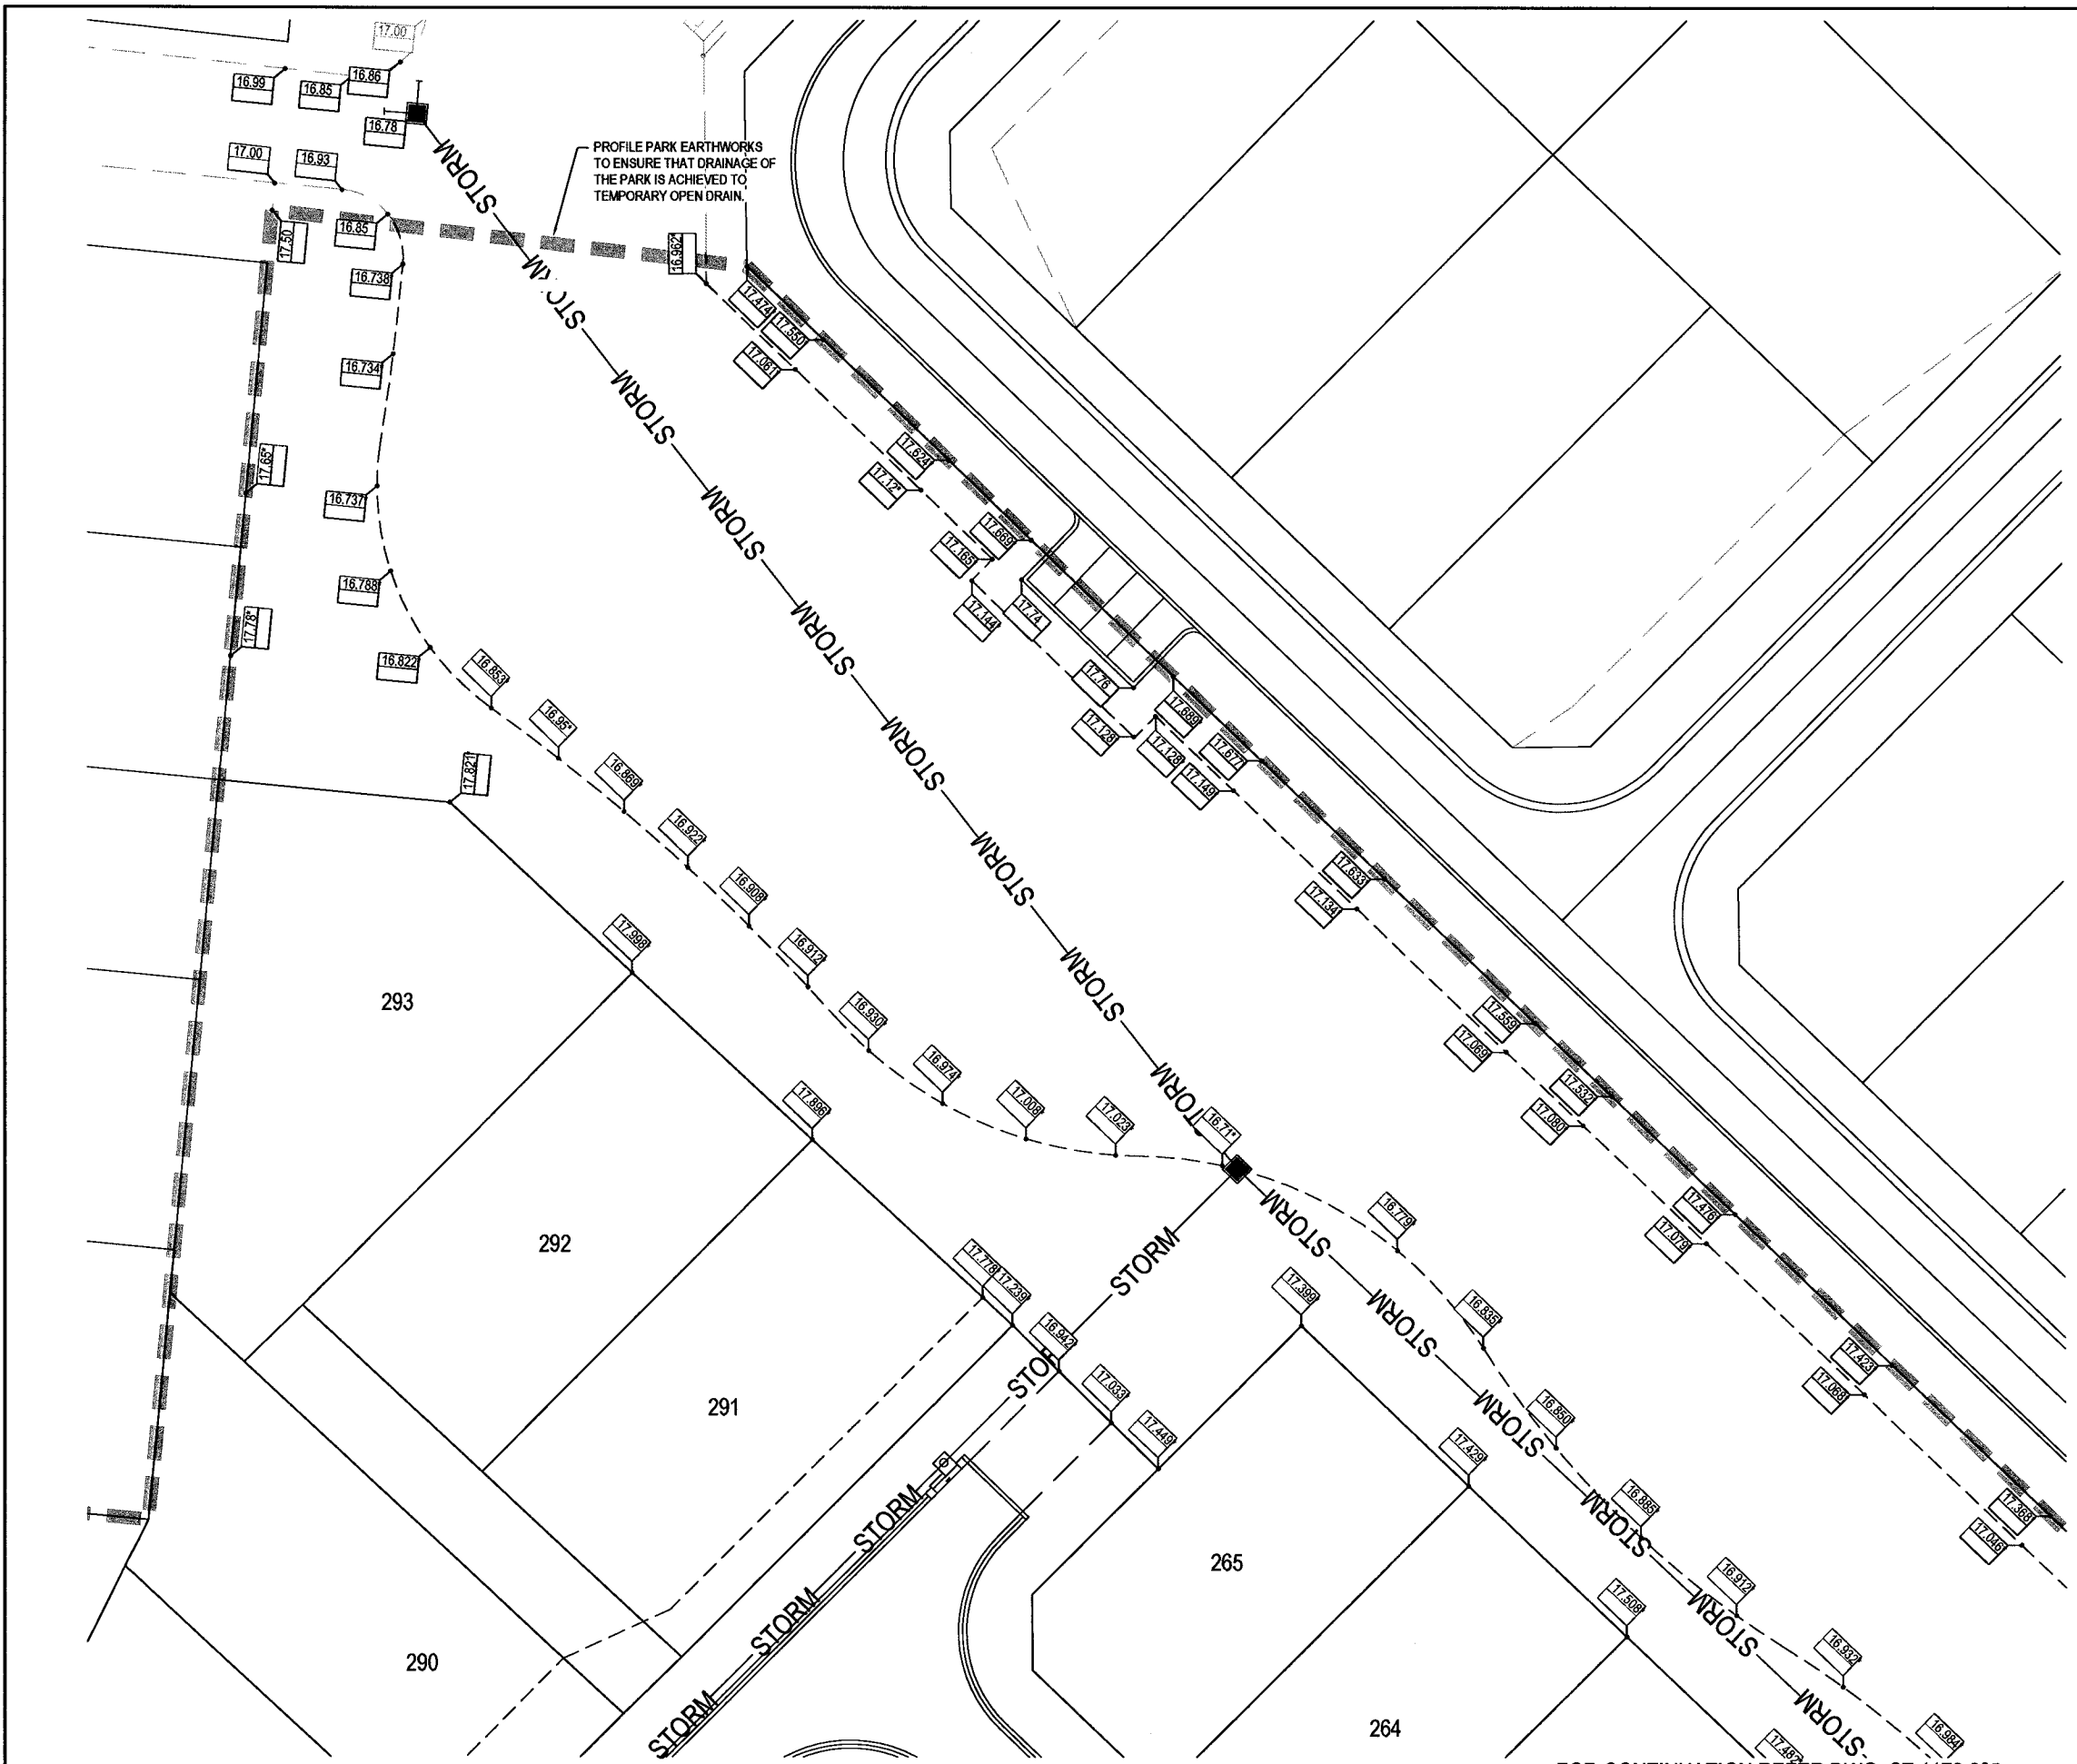FOR CONTINUATION REFER DWG. CT-1172-205



No.	Amendments	By	Appd	Date	No.	Amendments	By	Appd	Date
B	TEXT IN PARK REMOVED	JAM	<i>[Signature]</i>	08.12.06					
A	ORIGINAL ISSUE	CH	JL	16.11.06					

THIS DRAWING CANNOT BE COPIED OR REPRODUCED IN ANY FORM OR USED FOR ANY OTHER PURPOSE OTHER THAN THAT ORIGINALLY INTENDED WITHOUT THE WRITTEN PERMISSION OF BMD CONSULTING PTY LTD.

<b>Civil Engineers</b> <b>Structural Engineers</b> <b>Project Managers</b> <small>ABN 23 010 743 692</small>		Design	CH	<b>Client</b> <b>URBEX Pty Ltd</b>		
		Drawn	JAM		<b>Project</b> <b>KALYNDA CHASE - STAGE 3</b>	
<small>Townsville Office 57 Mitchell Street Townsville P.O. Box 6008 Townsville MC, QLD 4810</small>	<small>Ph: (07) 4750 7000 Fax: (07) 4760 7077 email: bmd@bmd.com.au www.bmd.com.au</small>	<small>Head Office - Brisbane Ph: (07) 3893 1511 Sydney Office Ph: (02) 9898 5400</small>	<small>Calma Office Ph: (07) 4036 1544</small>	Checked		JAM
				Original Approved By:	JL	<b>Title</b> <b>"AS CONSTRUCTED" EARTHWORKS</b> <b>LAYOUT PLAN Sheet 5 of 5</b>
				RPEQ No.	5948	
				Date	NOV '06	
				Datum	A.H.D.	
				Rev	B	