



LEGEND

- DENOTES CONSTRUCTED BATTER AT 1 IN 6 SLOPE
- AS CONSTRUCTED SURFACE LEVEL

BRAZIER MOTTI PTY LTD. ACN 066 411 041
 595 FLINDERS ST. TOWNSVILLE, HEREBY CERTIFY THAT THIS DRAWING ACCURATELY AND CORRECTLY DESCRIBES AND RECORDS THE NATURE AND LOCATION OF THE WORKS DEPICTED BY ASTERISKS (*) HEREON AS THEY HAVE BEEN CONSTRUCTED FOR SUBDIVISION.


DIRECTOR
 LICENSED SURVEYOR & DIRECTOR

Dated This 15th day of May 2007

BATTER MAX 1 IN 1 GRADIENT



DESIGN LEVELS PROVIDED

REAR BATTER DETAIL
 NOT TO SCALE

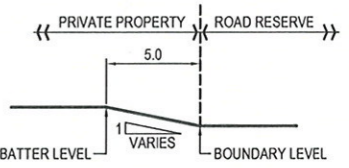

FRONT BATTER DETAIL
 NOT TO SCALE

DATUM
 PM No.131651 LOCATED ON
 HERVEY RANGE ROAD (BOLT IN BITUMEN)
 RL 19.248m AHD

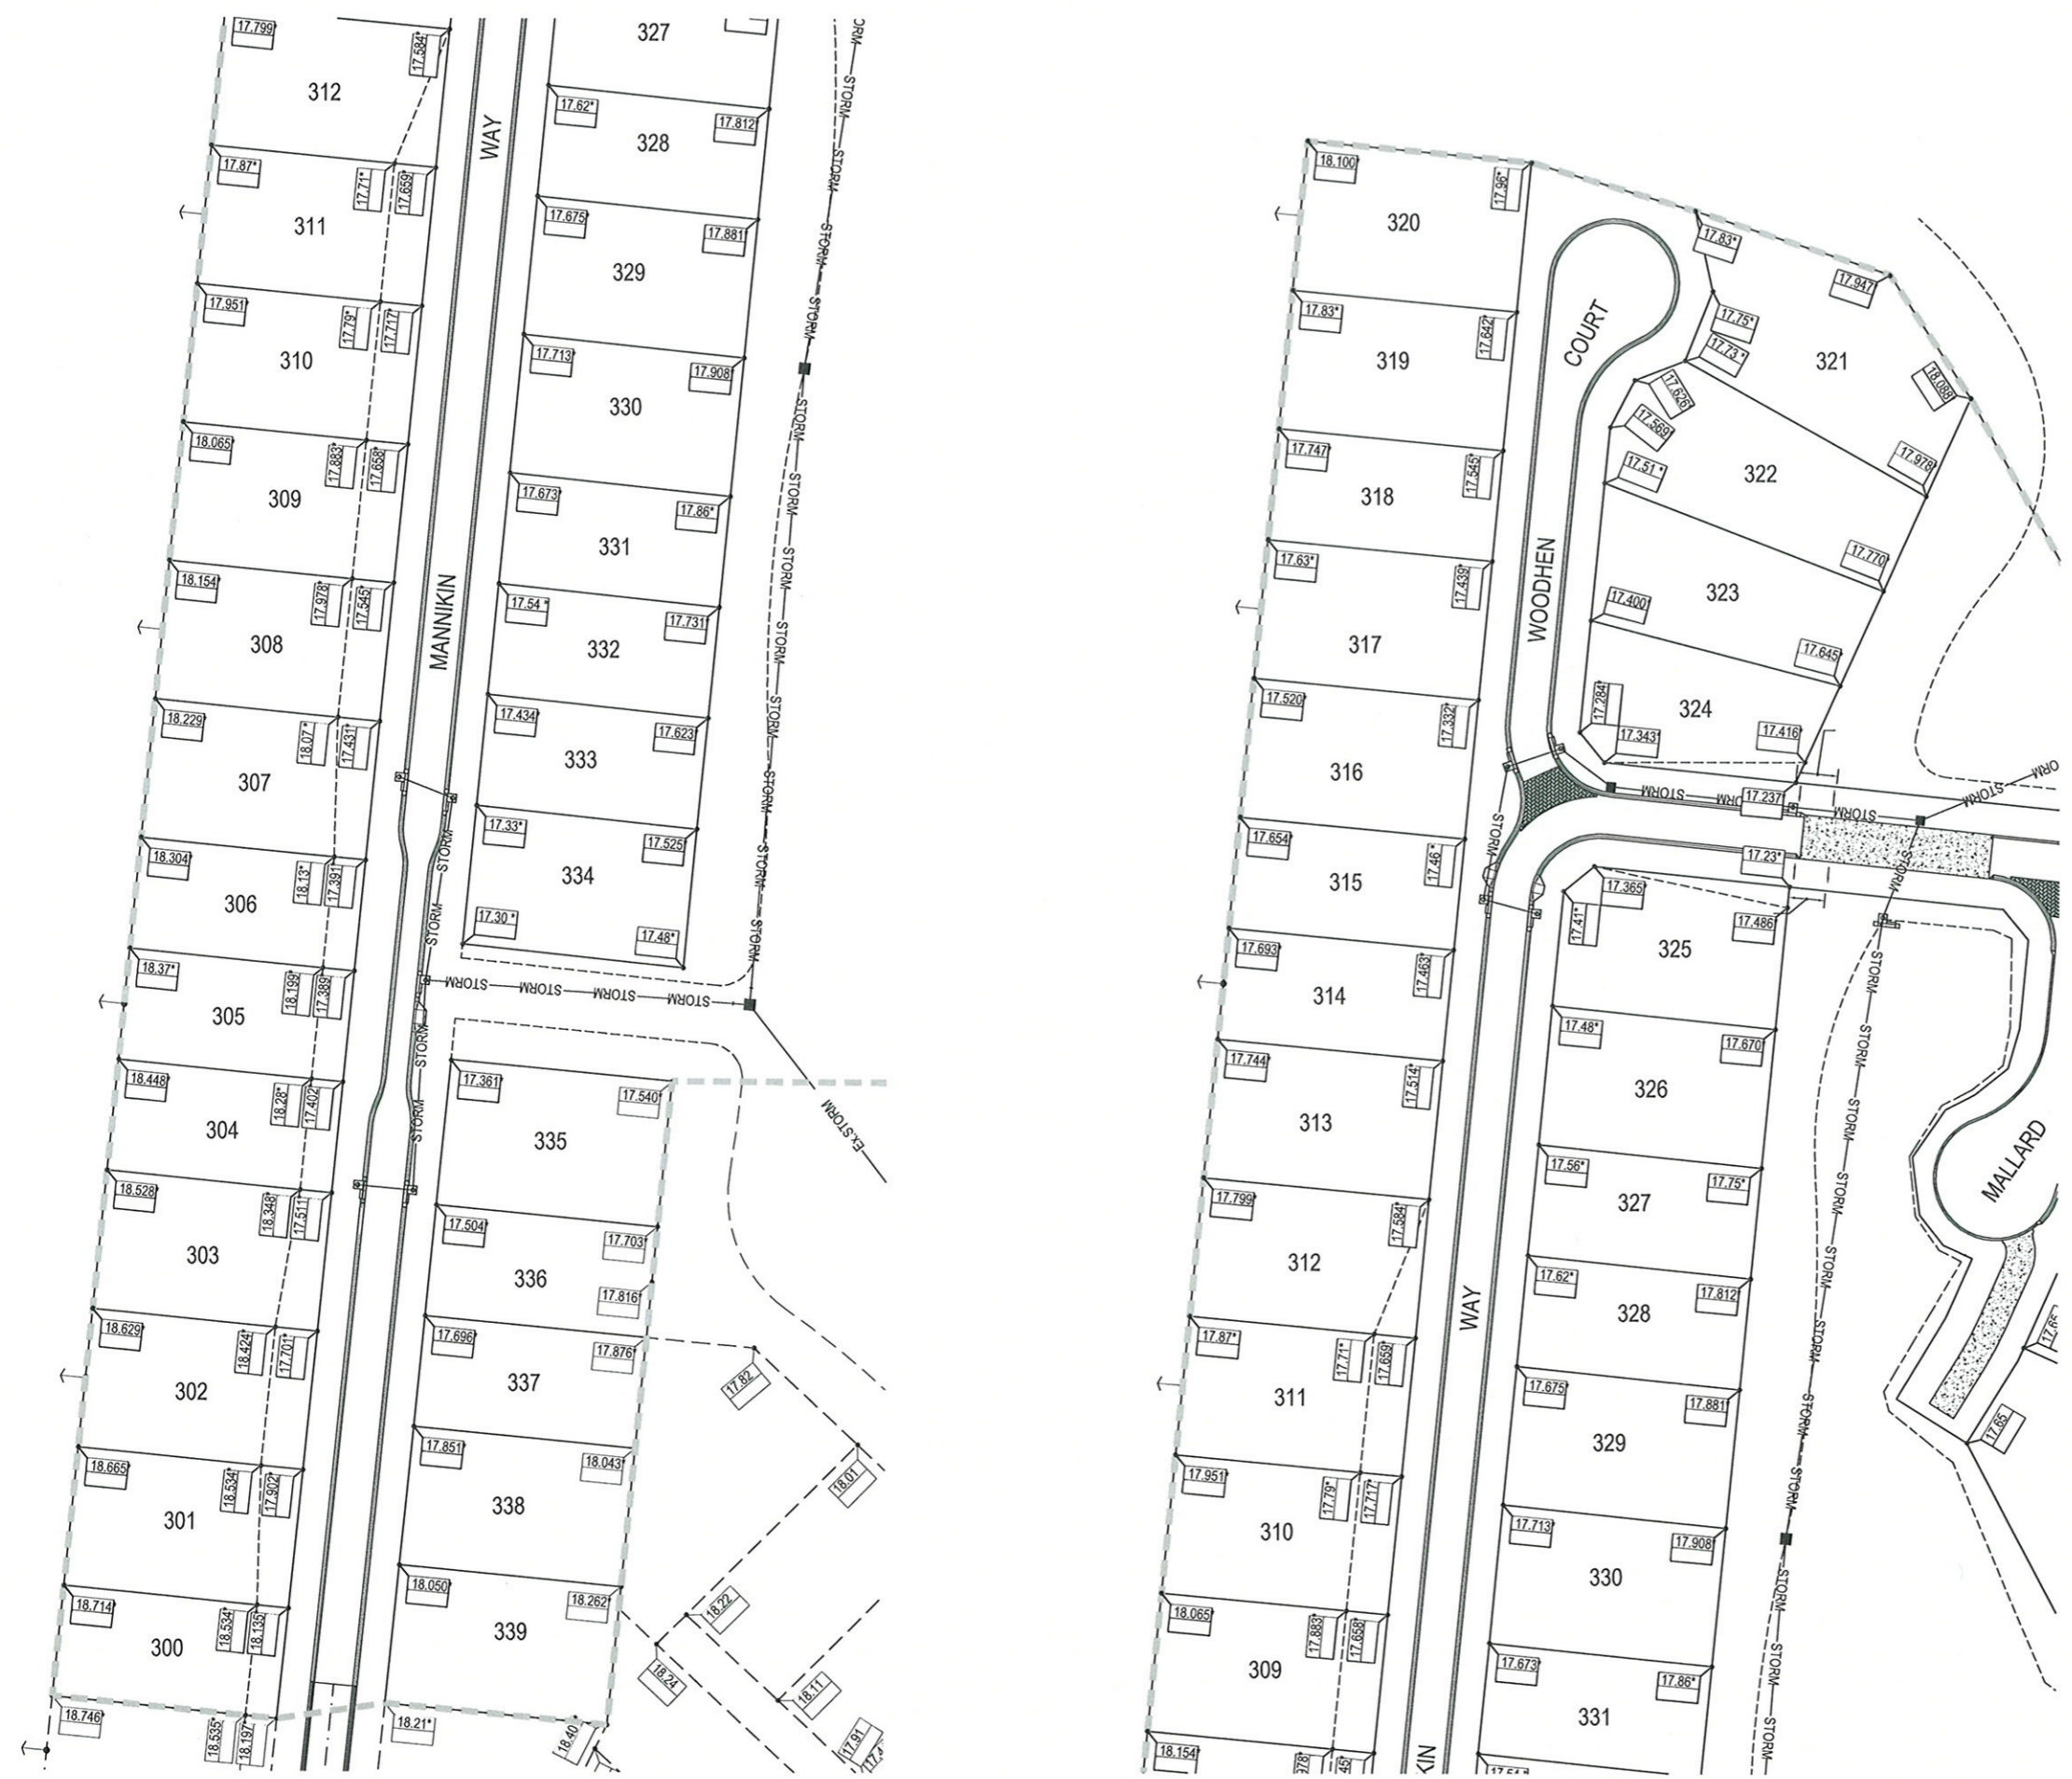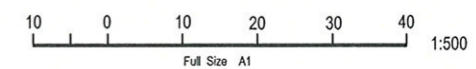

No.	Amendments	By	Appd	Date	No.	Amendments	By	Appd	Date
A	ORIGINAL ISSUE	S.J.J		14.05.07					

THIS DRAWING CANNOT BE COPIED OR REPRODUCED IN ANY FORM OR USED FOR ANY OTHER PURPOSE OTHER THAN THAT ORIGINALLY INTENDED WITHOUT THE WRITTEN PERMISSION OF BMD CONSULTING PTY LTD.

Civil Engineers
Structural Engineers
Project Managers

BMD
CONSULTING

ABN 23 010 743 692

Townsville Office: 57 Mitchell Street, P.O. Box 6008, Townsville MC, QLD 4810
 Ph: (07) 4750 7000, Fax: (07) 4750 7077, email: bmd@bmd.com.au, www.bmd.com.au

Head Office - Brisbane
Ph: (07) 3893 1511, email: bmd@bmd.com.au, Sydney Office Ph: (02) 9898 5400

Cairns Office
Ph: (07) 4035 1544

Design: S.J.J
 Drawn: W.E.S
 Checked: W.E.S
 Original Approved By: [Signature]
 RPEQ No.: 5948
 Date: MAY '07
 Datum: A.H.D.

Client: **URBEX Pty Ltd**

Project: **KALYNDA CHASE - STAGE 4C**

Title: **EARTHWORKS LAYOUT PLAN**

AS CONSTRUCTED

Drawing No. **CT-1173-801**

Rev **A**